



| W/O: |      | WORK ORDER CHANGES |    |      |     |                                     |                          |
|------|------|--------------------|----|------|-----|-------------------------------------|--------------------------|
| DATE | STEP | PROCEDURE CHANGE   | By | Date | Qty | Approval<br>Chief Eng /<br>Prod Mgr | Approval<br>QC Inspector |
|      |      |                    |    |      |     |                                     |                          |
|      |      |                    |    |      |     |                                     |                          |

Part No: \_\_\_\_\_ PAR #: \_\_\_\_\_ Fault Category: \_\_\_\_\_ NCR: Yes No DQA: \_\_\_\_\_ Date: \_\_\_\_\_  
 QA: N/C Closed: \_\_\_\_\_ Date: \_\_\_\_\_

| NCR:     |      | WORK ORDER NON-CONFORMANCE (NCR)   |                             |                                 |                 |                           |                       |                          |
|----------|------|--|-----------------------------|---------------------------------|-----------------|---------------------------|-----------------------|--------------------------|
| DATE     | STEP | Description of NC<br>Section A   | Corrective Action Section B |                                 |                 | Verification<br>Section C | Approval<br>Chief Eng | Approval<br>QC Inspector |
|          |      |  | Initial<br>Chief Eng        | Action Description<br>Chief Eng | Sign &<br>Date  |                           |                       |                          |
| 07/08/04 | 2    | 1 piece scrap, the piece<br><del>are</del> are .030" off on the<br>"x" axis. the dimensions<br>.500" are .470" @ the<br>bushing hole location. | WJL<br>07/08/27             | scrap and replace               | owl<br>07/08/04 | JM                        | WJS<br>07/08/27       | J<br>07/08/24            |
|          |      |  |                             |                                 |                 |                           |                       |                          |
|          |      |  |                             |                                 |                 |                           |                       |                          |

NOTE: Date & initial all entries

Date: Thursday, 7/10/2008 2:27:45 PM

User: Kim Johnston

## Process Sheet

Customer: CU-DAR001 Dart Helicopters Services

Drawing Name: 206/OH-58 SADDLE, INBOARD, RIGHT SIDE

Job Number: 33669

Part Number: D29392

Job Number:



Seq. #: Machine Or Operation:

Description :

5.0 QC8

SECOND CHECK



Comment: SECOND CHECK

SD 07.08.16

6.0 HAND FINISHING1

HAND FINISHING RESOURCE #1



Comment: HAND FINISHING RESOURCE #1

Acid etch and Alodine as per QSI 005 4.1

BL / FD

07/08/17 ⑩ P

7.0 POWDER COATING

POWDER COATING



M 105068

⑩

Comment: POWDER COATING

Powder Coat White Gloss (Ref: 4.3.5.1) as per QSI 005 4.3

BL/M. 07-08-20

8.0 QC3

INSPECT POWDER COAT/CHEMICAL CONVERSION



H8/22 SD

Comment: INSPECT POWDER COAT

9.0 PACKAGING 1

PACKAGING RESOURCE #1



Comment: PACKAGING RESOURCE #1

Identify and Stock

Location: \_\_\_\_\_

CJ 07/08/22 ⑩

10.0 QC21

FINAL INSPECTION/W/O RELEASE



Comment: FINAL INSPECTION/W/O RELEASE

Job Completion



U 07.08.23

| W/O: |      | WORK ORDER CHANGES |  |    |      |     |                                     |                          |
|------|------|--------------------|--|----|------|-----|-------------------------------------|--------------------------|
| DATE | STEP | PROCEDURE CHANGE   |  | By | Date | Qty | Approval<br>Chief Eng /<br>Prod Mgr | Approval<br>QC Inspector |
|      |      |                    |  |    |      |     |                                     |                          |
|      |      |                    |  |    |      |     |                                     |                          |

Part No: \_\_\_\_\_ PAR #: \_\_\_\_\_ Fault Category: \_\_\_\_\_ NCR: Yes No DQA: \_\_\_\_\_ Date: \_\_\_\_\_

QA: N/C Closed: \_\_\_\_\_ Date: \_\_\_\_\_

| NCR: |      | WORK ORDER NON-CONFORMANCE (NCR) |                             |                                 |                |                           |                       |                          |
|------|------|----------------------------------|-----------------------------|---------------------------------|----------------|---------------------------|-----------------------|--------------------------|
| DATE | STEP | Description of NC<br>Section A   | Corrective Action Section B |                                 |                | Verification<br>Section C | Approval<br>Chief Eng | Approval<br>QC Inspector |
|      |      |                                  | Initial<br>Chief Eng        | Action Description<br>Chief Eng | Sign &<br>Date |                           |                       |                          |
|      |      |                                  |                             |                                 |                |                           |                       |                          |
NOTE: Date & initial all entries

|  |              |             |
|--|--------------|-------------|
| DART AEROSPACE LTD                           | Work Order:  | 33669       |
| Description: 206 Saddle, Inboard, Right side | Part Number: | D2939-2     |
| Inspection Dwg: D2939 Rev. C                 |              | Page 1 of 1 |

Inspect dimensions highlighted on inspection sheet drawing D2939 Rev. C and record below:

| Dim           | Min   | Max   | Go/No Go Gauge | Recorded Actual Dimensions |       |       |       | By | Date |
|---------------|-------|-------|----------------|----------------------------|-------|-------|-------|----|------|
|               |       |       |                | 1                          | 2     | 3     | 4     |    |      |
| A             | 0.100 | 0.140 |                | 0.127                      | 0.128 | 0.128 | 0.124 |    |      |
| B             | 0.100 | 0.140 |                | 0.136                      | 0.130 | 0.130 | 0.127 |    |      |
| C             | 0.100 | 0.140 |                | 0.114                      | 0.116 | 0.188 | 0.115 |    |      |
| D             | 0.210 | 0.230 |                | 0.224                      | 0.223 | 0.224 | 0.224 |    |      |
| E             | 1.245 | 1.255 |                | 1.249                      | 1.249 | 1.250 | 1.249 |    |      |
| F             | 1.245 | 1.255 |                | 1.249                      | 1.249 | 1.249 | 1.249 |    |      |
| G             | 2.495 | 2.505 |                | 2.499                      | 2.499 | 2.506 | 2.506 |    |      |
| H             | 0.510 | 0.515 |                | 0.510                      | 0.510 | 0.510 | 0.510 |    |      |
| I             | 1.572 | 1.582 |                | 1.578                      | 1.576 | 1.576 | 1.576 |    |      |
| J             | 2.495 | 2.505 |                | 2.499                      | 2.499 | 2.499 | 2.499 |    |      |
| K             | 0.257 | 0.262 |                | 0.258                      | 0.258 | 0.258 | 0.258 |    |      |
| L             | 0.312 | 0.317 |                | 0.314                      | 0.314 | 0.314 | 0.314 |    |      |
| M             | 0.235 | 0.240 |                | 0.238                      | 0.238 | 0.239 | 0.238 |    |      |
| N             | 0.100 | 0.140 |                | 0.121                      | 0.121 | 0.122 | 0.121 |    |      |
| O             | 0.540 | 0.560 |                | 0.550                      | 0.550 | 0.550 | 0.550 |    |      |
| P             | 0.490 | 0.510 |                | 0.503                      | 0.502 | 0.502 | 0.501 |    |      |
| Q             | 3.715 | 3.725 |                | 3.717                      | 3.717 | 3.717 | 3.717 |    |      |
| R             | 2.720 | 2.760 |                | 2.746                      | 2.746 | 2.746 | 2.746 |    |      |
| S             | 0.240 | 0.270 |                | 0.253                      | 0.256 | 0.256 | 0.255 |    |      |
| T             | 0.100 | 0.180 |                | 0.134                      | 0.136 | 0.138 | 0.140 |    |      |
| U             | 1.625 | 1.635 |                | 1.628                      | 1.628 | 1.628 | 1.628 |    |      |
| V             | 1.362 | 1.372 |                | 1.366                      | 1.366 | 1.366 | 1.366 |    |      |
| W             | 0.316 | 0.321 |                | 0.320                      | 0.320 | 0.320 | 0.320 |    |      |
| X             | 1.250 | 1.270 |                | 1.264                      | 1.262 | 1.260 | 1.261 |    |      |
| Y             | 1.565 | 1.585 | DT8695 A/B     | 1.577                      | 1.574 | 1.574 | 1.573 |    |      |
| Z             | 0.178 | 0.198 |                | 0.188                      | 0.188 | 0.188 | 0.188 |    |      |
| AA            |       |       |                |                            |       |       |       |    |      |
| AB            |       |       |                |                            |       |       |       |    |      |
| AC            |       |       |                |                            |       |       |       |    |      |
| AD            |       |       |                |                            |       |       |       |    |      |
| AE            |       |       |                |                            |       |       |       |    |      |
| AF            |       |       |                |                            |       |       |       |    |      |
| AG            |       |       |                |                            |       |       |       |    |      |
| AH            |       |       |                |                            |       |       |       |    |      |
| Accept/Reject |       |       |                |                            |       |       |       |    |      |

|              |            |             |           |
|--------------|------------|-------------|-----------|
| Measured by: | <i>DMR</i> | Audited by: | <i>SA</i> |
| Date:        | 07/08/16   | Date:       | 07.08.16  |

| Rev | Date     | Change   | Revised by       | Approved  |
|-----|----------|--|------------------|-----------|
| A   |          | New Issue  | RF               |           |
| B   | 02.12.12 | Re-format; Added Dim. X-Y, DT8683, DT8686, DT8690 & DT8695 A/B | KJ/RF            |           |
| C   | 07.03.21 | Revised per drawing revision C                                 | KJ/JLM <i>JL</i> | <i>JL</i> |

|  |              |             |
|--|--------------|-------------|
| DART AEROSPACE LTD                           | Work Order:  | 33669       |
| Description: 206 Saddle, Inboard, Right side | Part Number: | D2939-2     |
| Inspection Dwg: D2939 Rev. C                 |              | Page 1 of 1 |

Inspect dimensions highlighted on inspection sheet drawing D2939 Rev. C and record below:

|               |       |       |                | Recorded Actual Dimensions |       |       |       |    |      |
|---------------|-------|-------|----------------|----------------------------|-------|-------|-------|----|------|
| Dim           | Min   | Max   | Go/No Go Gauge | 1                          | 2     | 3     | 4     | By | Date |
| A             | 0.100 | 0.140 |                | 0.126                      | 0.127 | 0.127 | 0.127 |    |      |
| B             | 0.100 | 0.140 |                | 0.128                      | 0.127 | 0.128 | 0.128 |    |      |
| C             | 0.100 | 0.140 |                | 0.116                      | 0.117 | 0.114 | 0.117 |    |      |
| D             | 0.210 | 0.230 |                | 0.224                      | 0.224 | 0.224 | 0.224 |    |      |
| E             | 1.245 | 1.255 |                | 1.250                      | 1.250 | 1.249 | 1.249 |    |      |
| F             | 1.245 | 1.255 |                | 1.249                      | 1.250 | 1.249 | 1.249 |    |      |
| G             | 2.495 | 2.505 |                | 2.499                      | 2.500 | 2.500 | 2.500 |    |      |
| H             | 0.510 | 0.515 |                | 0.510                      | 0.510 | 0.510 | 0.510 |    |      |
| I             | 1.572 | 1.582 |                | 1.576                      | 1.576 | 1.576 | 1.577 |    |      |
| J             | 2.495 | 2.505 |                | 2.500                      | 2.500 | 2.500 | 2.500 |    |      |
| K             | 0.257 | 0.262 |                | 0.258                      | 0.258 | 0.258 | 0.258 |    |      |
| L             | 0.312 | 0.317 |                | 0.314                      | 0.314 | 0.314 | 0.314 |    |      |
| M             | 0.235 | 0.240 |                | 0.238                      | 0.238 | 0.238 | 0.238 |    |      |
| N             | 0.100 | 0.140 |                | 0.121                      | 0.121 | 0.121 | 0.121 |    |      |
| O             | 0.540 | 0.560 |                | 0.556                      | 0.551 | 0.550 | 0.551 |    |      |
| P             | 0.490 | 0.510 |                | 0.502                      | 0.503 | 0.502 | 0.503 |    |      |
| Q             | 3.715 | 3.725 |                | 3.718                      | 3.718 | 3.718 | 3.718 |    |      |
| R             | 2.720 | 2.760 |                | 2.746                      | 2.746 | 2.746 | 2.746 |    |      |
| S             | 0.240 | 0.270 |                | 0.256                      | 0.255 | 0.256 | 0.256 |    |      |
| T             | 0.100 | 0.180 |                | 0.140                      | 0.140 | 0.140 | 0.140 |    |      |
| U             | 1.625 | 1.635 |                | 1.628                      | 1.628 | 1.628 | 1.628 |    |      |
| V             | 1.362 | 1.372 |                | 1.366                      | 1.366 | 1.366 | 1.367 |    |      |
| W             | 0.316 | 0.321 |                | 0.320                      | 0.320 | 0.320 | 0.320 |    |      |
| X             | 1.250 | 1.270 |                | 1.261                      | 1.261 | 1.260 | 1.260 |    |      |
| Y             | 1.565 | 1.585 | DT8695 A/B     | 1.574                      | 1.573 | 1.574 | 1.573 |    |      |
| Z             | 0.178 | 0.198 |                | 0.188                      | 0.188 | 0.188 | 0.188 |    |      |
| AA            |       |       |                |                            |       |       |       |    |      |
| AB            |       |       |                |                            |       |       |       |    |      |
| AC            |       |       |                |                            |       |       |       |    |      |
| AD            |       |       |                |                            |       |       |       |    |      |
| AE            |       |       |                |                            |       |       |       |    |      |
| AF            |       |       |                |                            |       |       |       |    |      |
| AG            |       |       |                |                            |       |       |       |    |      |
| AH            |       |       |                |                            |       |       |       |    |      |
| Accept/Reject |       |       |                |                            |       |       |       |    |      |

|              |            |             |           |
|--------------|------------|-------------|-----------|
| Measured by: | <i>cmk</i> | Audited by: | <i>SD</i> |
| Date:        | 07/08/05   | Date:       | 07.08.16  |

| Rev | Date     | Change   | Revised by       | Approved   |
|-----|----------|--|------------------|------------|
| A   |          | New Issue  | RF               |            |
| B   | 02.12.12 | Re-format; Added Dim. X-Y, DT8683, DT8686, DT8690 & DT8695 A/B | KJ/RF            |            |
| C   | 07.03.21 | Revised per drawing revision C                                 | KJ/JLM <i>JK</i> | <i>SPM</i> |


|  |              |             |
|--|--------------|-------------|
| DART AEROSPACE LTD                           | Work Order:  | 33669       |
| Description: 206 Saddle, Inboard, Right side | Part Number: | D2939-2     |
| Inspection Dwg: D2939 Rev. C                 |              | Page 1 of 1 |

Inspect dimensions highlighted on inspection sheet drawing D2939 Rev. C and record below:

|               |       |       |                | Recorded Actual Dimensions |       |   |   |    |      |
|---------------|-------|-------|----------------|----------------------------|-------|---|---|----|------|
| Dim           | Min   | Max   | Go/No Go Gauge | 1                          | 2     | 3 | 4 | By | Date |
| A             | 0.100 | 0.140 |                | 0.126                      | 0.126 |   |   |    |      |
| B             | 0.100 | 0.140 |                | 0.126                      | 0.126 |   |   |    |      |
| C             | 0.100 | 0.140 |                | 0.116                      | 0.117 |   |   |    |      |
| D             | 0.210 | 0.230 |                | 0.224                      | 0.224 |   |   |    |      |
| E             | 1.245 | 1.255 |                | 1.249                      | 1.249 |   |   |    |      |
| F             | 1.245 | 1.255 |                | 1.249                      | 1.249 |   |   |    |      |
| G             | 2.495 | 2.505 |                | 2.506                      | 2.506 |   |   |    |      |
| H             | 0.510 | 0.515 |                | 0.570                      | 0.570 |   |   |    |      |
| I             | 1.572 | 1.582 |                | 1.576                      | 1.576 |   |   |    |      |
| J             | 2.495 | 2.505 |                | 2.506                      | 2.506 |   |   |    |      |
| K             | 0.257 | 0.262 |                | 0.258                      | 0.258 |   |   |    |      |
| L             | 0.312 | 0.317 |                | 0.314                      | 0.314 |   |   |    |      |
| M             | 0.235 | 0.240 |                | 0.238                      | 0.238 |   |   |    |      |
| N             | 0.100 | 0.140 |                | 0.121                      | 0.121 |   |   |    |      |
| O             | 0.540 | 0.560 |                | 0.551                      | 0.551 |   |   |    |      |
| P             | 0.490 | 0.510 |                | 0.503                      | 0.501 |   |   |    |      |
| Q             | 3.715 | 3.725 |                | 3.718                      | 3.718 |   |   |    |      |
| R             | 2.720 | 2.760 |                | 2.740                      | 2.746 |   |   |    |      |
| S             | 0.240 | 0.270 |                | 0.256                      | 0.256 |   |   |    |      |
| T             | 0.100 | 0.180 |                | 0.135                      | 0.135 |   |   |    |      |
| U             | 1.625 | 1.635 |                | 1.628                      | 1.628 |   |   |    |      |
| V             | 1.362 | 1.372 |                | 1.366                      | 1.366 |   |   |    |      |
| W             | 0.316 | 0.321 |                | 0.320                      | 0.320 |   |   |    |      |
| X             | 1.250 | 1.270 |                | 1.261                      | 1.260 |   |   |    |      |
| Y             | 1.565 | 1.585 | DT8695 A/B     | 1.573                      | 1.573 |   |   |    |      |
| Z             | 0.178 | 0.198 |                | 0.188                      | 0.188 |   |   |    |      |
| AA            |       |       |                |                            |       |   |   |    |      |
| AB            |       |       |                |                            |       |   |   |    |      |
| AC            |       |       |                |                            |       |   |   |    |      |
| AD            |       |       |                |                            |       |   |   |    |      |
| AE            |       |       |                |                            |       |   |   |    |      |
| AF            |       |       |                |                            |       |   |   |    |      |
| AG            |       |       |                |                            |       |   |   |    |      |
| AH            |       |       |                |                            |       |   |   |    |      |
| Accept/Reject |       |       |                |                            |       |   |   |    |      |


|              |                 |             |                 |
|--------------|-----------------|-------------|-----------------|
| Measured by: | <i>JML</i>      | Audited by: | <i>01.08.16</i> |
| Date:        | <i>07/08/05</i> | Date:       | <i>SA</i>       |

| Rev | Date     | Change   | Revised by               | Approved           |
|-----|----------|--|--------------------------|--------------------|
| A   |          | New Issue  | RF                       |                    |
| B   | 02.12.12 | Re-format; Added Dim. X-Y, DT8683, DT8686, DT8690 & DT8695 A/B | KJ/RF                    |                    |
| C   | 07.03.21 | Revised per drawing revision C                                 | KJ/JLM <i>[initials]</i> | <i>[Signature]</i> |

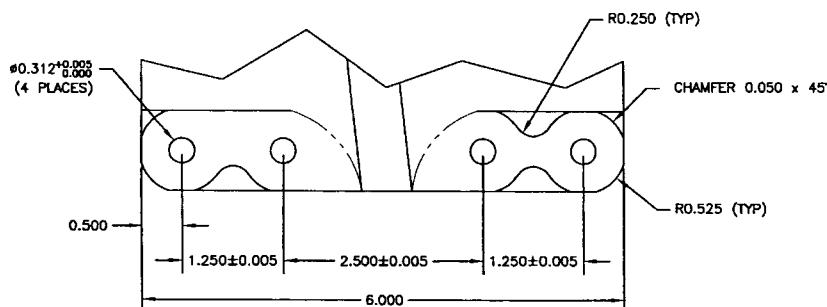


VIEW C-C

D2939-1 LH SADDLE (SHOWN)  
D2939-2 RH SADDLE (OPPOSITE)

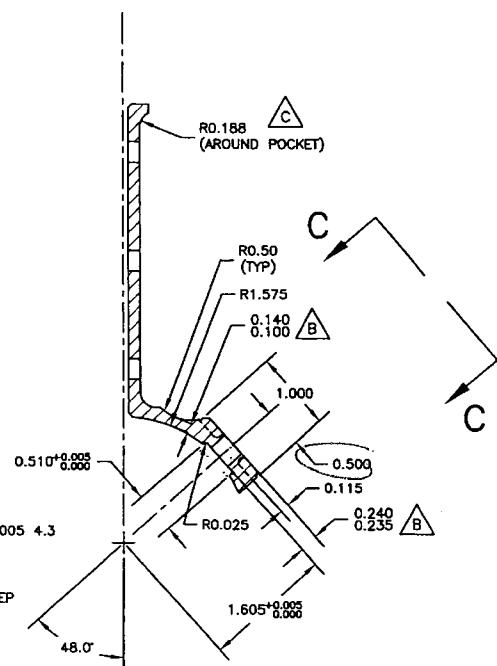


SECTION B-B

CHAMFER 0.050 x 45° AROUND THE SURFACE (TYP 2 PLACES)

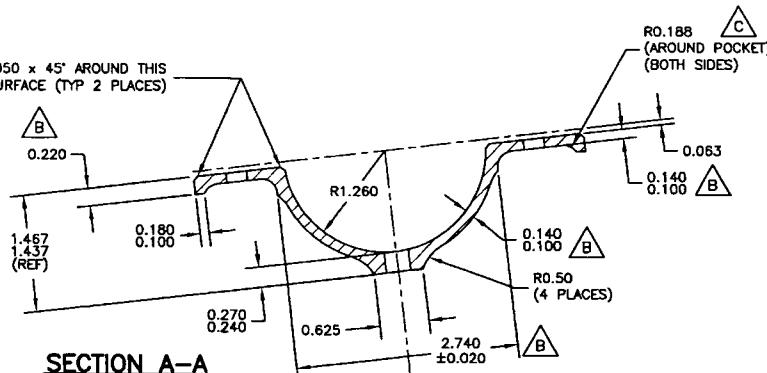

SECTION A-A

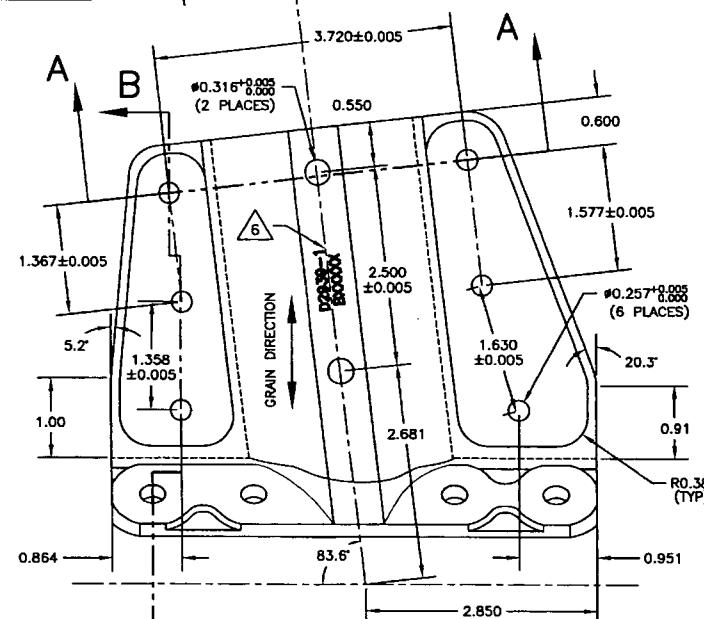

8

|  |   |  |
|--|---|--|
| C  | 06.11.09  | RO.188 WAS RO.30 TO RO.25                            |
| B  | 00.05.29  | CHANGED DEOMETRY AND MATERIAL.                       |
| A  | 99.11.12  | NEW ISSUE  |
| DESIGN<br>  | DRAWN BY<br> | <b>DART</b> DART AEROSPACE USA, INC.<br>BELLEVUE, WA |
| CHECKED<br> | APPROVED<br> | DRAWING NO. D2939 REV. C<br>SHEET 1 OF 1             |
| DATE<br>06.11.09   | TITLE<br>SADDLE INSIDE  | SCALE<br>2:3   |

01-02-12 ~~off~~

SHOP COPY  
RETURN TO  
ENGINEERING  
UNCONTROLLED COPY  
SUBJECT TO AMENDMENT  
WITHOUT NOTICE  
WORK ORDER  
NO. 33669

www.ijerpi.org | 10(1) 2021 | ISSN: 2231-8722

THIS DOCUMENT IS PRIVATE AND CONFIDENTIAL  
AND IS SUPPLIED ON THE EXPRESS CONDITION  
THAT IT IS NOT TO BE USED FOR ANY PURPOSE  
OR COPIED OR COMMUNICATED TO ANY OTHER  
PERSON WITHOUT WRITTEN PERMISSION FROM  
DART AEROSPACE USA, INC.